


Building 304
Conference Centre

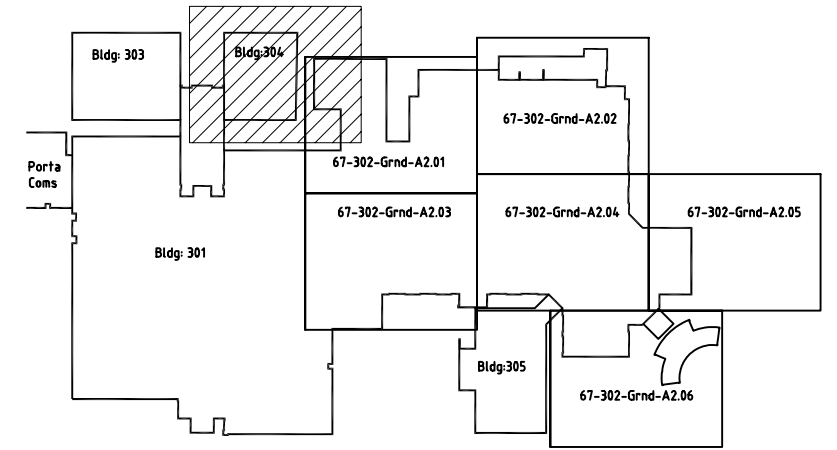

Conference Centre:
Building 304

In preparing these drawings all care has been taken in identifying items & positioning them correctly on the drawings. It must be noted that discrepancies may occur, so before attempting any work, All dimensions and positions must be checked on site. All equipment to be worked on must be made safe, in no way should patient safety be compromised

No.	Revision	By	Chk	Appd	Date
1	Room Numbers Added	SF	CB	CB	17 Aug 2010
A	New Drawing Set-up	S,F	S,F		05 May 2010

Original Scale (A1)	Design	CMDHB	Approved for
1:100	Drawn	S,F	As Built
Reduced Scale (A3)	Dwg Check		Date
1:200	Dwg Check		17 Aug 2010

Client

Project

CMDHB Master Building Plans
Site 67 Manukau Super Clinic
& Elective Surgery Centre

Title		
Manukau Super Clinic Building 304 Conference Ground Floor Plan		
CMDHB Number	Drawing Number	Rev
1020-67	67-304-Grnd-A2.01	A